

**ADDENDUM NO. ONE (1)
TOWN OF BRASELTON, GEORGIA
2026 GROUNDWATER EXPANSION AND DISTRIBUTION STORAGE
ISSUED JANUARY 15, 2026**

RE: 2026 GROUNDWATER EXPANSION AND DISTRIBUTION STORAGE
EMI PROJECT No. 18-021

FROM: ENGINEERING MANAGEMENT, INC.
303 SWANSON DRIVE
LAWRENCEVILLE, GA 30043
WILEY HELM, P.E.

TO: PROSPECTIVE BIDDERS

This Addendum forms a part of the Contract Documents and Drawings and modifies the original bidding documents dated December 2025.

The purpose of this Addendum is to provide additional equipment information where necessary note minor changes to the Drawings. The following items of the Contract Documents are modified as part of this Addendum:

Clarifications

1. Erosion Control drawings EC-A through EC-C have been updated for permitting requirements.
2. Does the above project currently have an estimated value or mobilization date?

EMI Response: The opinion of probable cost is \$8.5-million. The mobilization date will be determined by all parties at the pre-construction meeting. Expected timeline for mobilization would be Q2 of 2026.

3. What material is the ground water storage tank to be constructed out of?

EMI Response: The storage tank will be constructed out of pre-stressed concrete.

4. Is there a specified manufacturer for the well pumps?

EMI Response: The well pumps used Grundfos for the basis of design. Equal manufacturers include Franklin Electric or Goulds. Specification Section 11216 will be revised accordingly.

5. What is the duty point for the in-line multi-stage pumps?

EMI Response: The in-line multi-stage pumps were designed to operate in parallel. The duty point with both pumps running is 2,800 GPM at 435ft of TDH. Specification Section 11230 will be revised accordingly.

6. Please clarify the number of chemical storage tanks specified in Section 11244?

EMI Response: The total number of chemical tanks provided by the Contractor is four (4). Specification Section 11244 will be revised accordingly.

Plans

- *Plan sheets EC-A, EC-B, and EC-C have been revised. See attached revised plan sheets.*

Specifications

- *Section 11216, Deep Well Submersible Pump*

Add paragraph 2.02.A (revisions are shown in bold and italics below):

A. Manufacturers – Provide equipment from one of the following:

1. ***Grundfos***
2. ***Goulds***
3. ***Franklin Electric***
4. ***Or approved equal***

- *Section 11230, In-line Multi-Stage Pumps*

Add paragraph 2.01.A and B (revisions are shown in bold and italics below):

A. The pump(s) shall be selected to meet the following criteria:

1. ***Parallel Pumping (both (2) pumps on)***
 - a. ***2,800 gpm @ 435' TDH***

B. Manufacturers – Provide equipment from one of the following:

1. ***Grundfos***
2. ***Approved equal***

- *Section 11244, Chemical Storage Tanks*

Revise paragraph 2.03.A as follows (revisions are shown in bold and italics below):

2.03 SERVICE CONDITIONS

A. The CONTRACTOR shall supply ***four*** (4) HDPE chemical storage tanks, ***two*** (2) for storage of caustic soda and two (2) for the storage of sodium hypochlorite. The caustic soda bulk storage tank shall have a capacity of 1,500 gallons and be double walled with a flat bottom and domed top. The caustic soda day tank shall have a capacity of 50 gallons with a flat bottom. The sodium hypochlorite bulk storage tank shall have a capacity of 1,000 gallons and be double walled with a flat bottom and domed top. The sodium hypochlorite day tank shall have a capacity of 50 gallons with a flat bottom.

END OF ADDENDUM NO. 1

Z:\PROJECTS\18\18021-Braselton-Groundwater Investigation-2018\Bid Phase\Addendum No. 1\18021 Addendum No 1 20260115.doc

2026 - 2027											
MONTHS											
5	6	7	8	9	10	11	12	1	2	3	4
EROSION CONTROL INSTALLATION OF SILT FENCE, AND CHECK DAMS.											
Cd		Sd1									
ROUGH GRADING INSTALLATION OF STORM DRAINS, TRENCH EXCAVATION AND BACKFILLING FOR UTILITIES											
FINAL GRADING, CONSTRUCTION OF THE BUILDINGS, UTILITY EXCAVATION AND BACK FILLING											
INSTALLATION OF MULCHING AND/OR PERMANENT GRASSING IN AREAS WHERE WORK IS COMPLETE AND IN DISTURBED AREAS LEFT EXPOSED FOR GREATER THAN 14 DAYS											
Ds1		Ds3									
MAINTAIN INSTALLED EROSION CONTROL BMP'S UNTIL PERMANENT VEGETATION IS ESTABLISHED AND EFFECTIVE CONTROL OF EROSION HAS BEEN ACHIEVED IN DISTURBED AREAS WHERE WORK IS COMPLETE											
Cd		Sd1		Ds1		Ds3					
CERTIFICATION - ES&PC DESIGN PROFESSIONAL											
"I certify under penalty of law that this plan was prepared after a site visit to the locations described herein by myself or my authorized agent, under my supervision."											
"I certify under penalty of law that this document and all attachments were prepared under my direction or supervision in accordance with a system designed to assure that qualified personnel properly gather and evaluate the information submitted. Based on my inquiry of the person or persons who manage the system, or those persons directly responsible for gathering the information, the information submitted is, to the best of my knowledge and belief, true, accurate, and complete. I am aware that there are significant penalties for submitting false information, including the possibility of fine and imprisonment for knowing violations."											
Wiley Helm 1/15/2026											
DATE 12/31/25 A ISSUED FOR BID 1/15/2026 B ISSUED FOR PERMITTING											
OWNER: THE TOWN OF BRASELTON 4982 HIGHWAY 53 PO BOX 306 BRASELTON, GA 30517 PHONE: 706-654-3915 FAX: 706-654-3109 WWW.BRASELTON.NET											
24 HOUR CONTACT: WATER SUPERINTENDENT JEB ZEIGLER 770-680-9349											
THE TOWN OF BRASELTON 4982 HIGHWAY 53 PO BOX 306 BRASELTON, GA 30517 PHONE: 706-654-3915											
UTILITY CONTRACTOR/PRIMARY PERMITTEE: TO BE DETERMINED AFTER BID PROCESS											
PLANS WILL BE RELEASED FOR CONSTRUCTION AFTER APPROVALS ARE RECEIVED FROM ALL AGENCIES.											
2026 GROUNDWATER EXPANSION AND DISTRIBUTION STORAGE FOR THE TOWN OF BRASELTON, GA											
EMI ENGINEERING MANAGEMENT Civil and Environmental Engineers Experience ■ Trust ■ Solutions 305 Watson Drive, Lawrenceville, GA 30043 phone 770-962-7040 www.emieng.com											
EROSION CONTROLS NOTES AND DETAILS SHEET TITLE WSH RSS GB CHECKED BY DESIGN BY DRAWN BY PROJECT NUMBER 18021_Braselton GroundWater EC											
STAMP 1/15/2026 DATE 18021 JOB NUMBER PATH & FILE: 2018/Design Stage 1/Braselton_Groundwater_Invigation/2018/Design Stage 1/Braselton_GroundWater EC											
SHEET EC-A											

NOTICE OF INTENT SUBMITTAL

NOIs are to be submitted to EPD using the electronic submittal service provided by EPD and a copy to the Local Issuing Authority in jurisdictions authorized to issue a Land Disturbance Activity permit for the permittee's construction site pursuant to O.C.G.A. 12-7-1, et seq. The permittee shall retain a copy of the proof of submittal at the construction site or the proof of submittal shall be readily available at a designated alternate location from commencement of construction until such time as a Notice of Termination (NOT) is submitted in accordance with Part VI.

INSPECTIONS AND RECORD KEEPING

a. PERMITTEE REQUIREMENTS

- Each day when any type of construction activity has taken place at a primary permittee's site, certified personnel provided by the primary permittee shall inspect: (a) all areas at the primary permittee's site where petroleum products are stored, used, or handled for spills and leaks from vehicles and equipment and (b) all locations at the primary permittee's site where vehicles enter or exit the site for evidence of off-site sediment tracking. These inspections must be conducted until a Notice of Termination is submitted.
- Measure and record rainfall within disturbed areas of the site that have not met final stabilization once every 24 hours except any non-working Saturday, non-working Sunday and non-working Federal holiday. The data collected for the purpose of compliance with this permit shall be representative of the monitored activity. Measurement of rainfall may be suspended if all areas of the site have undergone final stabilization or established a crop of annual vegetation and a seeding of target perennials appropriate for the region.
- Certified personnel (provided by the Primary Permittee) shall inspect the following at least once every fourteen (14) calendar days: (a) disturbed areas of the Primary Permittee's construction site; (b) areas used by the Primary Permittee for storage of materials that are exposed to precipitation; and (c) structural control measures. Erosion and sediment control measures identified in the Plan applicable to the Primary Permittee's site shall be observed to ensure they are operating correctly. Certified personnel shall also conduct inspections within 24 hours of the end of a storm that is 0.5 inches rainfall or greater (unless the storm ends after 5:00 PM on any Friday or on any non-working Saturday, non-working Sunday or any non-working Federal holiday in which case the inspection shall be completed by the end of the next business day and/or working day, whichever occurs first). Post-rain inspections will reset the 14-day inspection frequency requirement. Where discharge locations or points are accessible, they shall be inspected to ascertain whether erosion control measures are effective in preventing significant impacts to receiving water(s). For areas of a site that have undergone final stabilization or established a crop on annual vegetation and a seeding of target perennials appropriate for the region the permittee must comply with Part IV.D.4.a.(4). These inspections must be conducted until a Notice of Termination is submitted.
- Certified personnel (provided by the primary permittee) shall inspect at least once per month during the term of this permit (i.e., until a Notice of Termination is submitted to EPD) the areas of the site that have undergone final stabilization or established a crop of annual vegetation and a seeding of target perennials appropriate for the region. These areas shall be inspected for evidence of, or the potential for, pollutants entering the drainage system and the receiving water(s). Erosion and sediment control measures identified in the Plan shall be observed to ensure that they are operating correctly. Where discharge locations or points are accessible, they shall be inspected to ascertain whether erosion control measures are effective in preventing significant impacts to receiving water(s).

(5) Based on the results of each inspection, the site description and the pollution prevention and control measures identified in the Erosion, Sedimentation and Pollution Control Plan, the Plan shall be revised as appropriate not later than seven (7) calendar days following each inspection. Implementation of such changes shall be made as soon as practical but in no case later than seven (7) calendar days following each inspection.

(6) A report of each inspection that includes the name(s) of certified personnel making each inspection, the date(s) of each inspection, construction phase (i.e., initial, intermediate or final), major observations relating to the implementation of the Erosion, Sedimentation and Pollution Control Plan, and actions taken in accordance with Part IV.D.4.a.(5), of the permit shall be made and retained at the site or be readily available at a designated alternate location until the entire site or that portion of a construction site that has been phased has undergone final stabilization and a Notice of Termination is submitted to EPD. Such reports shall be readily available by end of the second business day and/or working day and shall identify all incidents of best management practices that have not been properly installed and/or maintained as described in the Plan. Where the report does not identify any incidents, the inspection report shall contain a statement that the best

SAMPLING REQUIREMENTS

- Sampling shall be performed at the locations indicated on the USGS topographic map, see sheet ECC of the construction plans. See Sheets EC1-1 - EC5-3 for detailed sample locations.
- Analytical methods used to collect and analyze the samples and quality control/guidance assurance procedures shall be in accordance with methodology and test procedures established by 40 CFR Part 136, the guidance document titled "NPDES Storm Water Sampling Guidance Document, EPA 833-B-92-001" and any other guidance documents that may be prepared by EPD.
- There is one (1) receiving waters located along the route of this project (see USGS Topographic Map, sheet ECC of the construction plans for locations of receiving water and sampling sites). The receiving waters includes one (1) unnamed tributary of Mulberry River.

State and Receiving Water 1: Unnamed tributary of Mulberry River

Storm water runoff from areas of construction within the watershed of this tributary is conveyed toward the unnamed tributary of Mulberry River as sheet flow and in roadside ditches. This unnamed tributary is located in close proximity to the project site. Sampling Points A1 & A2 will be located on the unnamed tributary of Mulberry River at the upstream and downstream side of the project respectively, approximately Stations 47+75, (sheet EC-3. The difference in NTU value (obtained from GAR 100002 Appendix B) for these sampling points is not to exceed 25. Storm water runoff from areas of construction that is not collected in roadside ditches leaves the site as sheet flow.

SAMPLE TYPE

- All sampling shall be collect by "grab samples" and the analysis of these samples must be conducted in accordance with methodology and test procedures established by 40 CFR Part 136, the guidance document titled "NPDES Storm Water Sampling Guidance Document, EPA 833-B-92-001" and guidance documents that may be prepared by the EPD.
- Sample containers shall be labeled prior to collecting the samples.
- Samples shall be well mixed before transferring to a secondary container.
- Large mouth, well cleaned and rinsed glass or plastic jars shall be used for collecting samples. The jars shall be cleaned thoroughly to avoid contamination.
- Manual, automatic or rising stage sampling may be utilized. Samples shall be analyzed immediately, but in no case later than 48 hours after collection. However, samples from automatic samplers must be collected no later than the next business day after their accumulation, unless flow through automated analysis is utilized. If Automatic sampling is utilized and the automatic sampler is not activated during the qualifying event, the contractor must utilize manual sampling or rising stage sampling during the next qualifying event. Delivery of samples is not required. Samples may be analyzed directly with a properly calibrated turbidimeter. Samples are not required to be cooled.
- Sampling and analysis of the receiving water(s) or outfalls beyond the minimum frequency required must be reported to EPD.

SAMPLE POINTS

- The upstream sample of the receiving water(s) must be taken immediately upstream of the confluence of the first point of storm water discharge from the project site. If necessary, several upstream samples from across the receiving water may need to be taken and the arithmetic average of the turbidity of these samples used for the upstream turbidity value.
- The downstream sample of the receiving water(s) must be taken immediately downstream of the last point of storm water discharge from the project site. If necessary, several downstream samples from across the receiving water may need to be taken and the arithmetic average of the turbidity of these samples used for the downstream turbidity value.
- Ideally, samples should be taken from the horizontal and vertical center of the receiving water(s) or the storm water outfall channel(s).
- Avoid stirring the bottom of the sediments in the receiving water(s) and/or outfall storm water channel.
- Hold sampling container so that opening faces upstream.
- Keep samples free from floating debris.
- Sampling must be done in accordance with all requirements of EPD Permit No. GAR100002 and in such a way as to accurately reflect whether storm water runoff from the site is in compliance with EPD Permit No. GAR100002.

SAMPLING FREQUENCY

- The Primary permittee must sample in accordance with the plan at least once for each rainfall event described below. For a qualifying event, the permittee shall sample at the beginning of any storm water discharge to monitor receiving water and/or from a monitored outfall location within forty-five (45) minutes or as soon as possible.
- However, where manual and automatic sampling are impossible (as defined in this permit), or are beyond the permittee's control, the permittee shall take samples as soon as possible, but in no case more than twelve (12) hours after the beginning of the storm water discharge.

(3) Sampling by the permittee shall occur for the following qualifying events.

- For each area of the site that discharges to a receiving water, or from an outfall, the first rain event that reaches or exceeds 0.5 inch with a storm water discharge that occurs during normal business hours* (Monday thru Friday, 8:00 AM to 5:00 PM and Saturday 8:00 AM to 5:00 PM when construction activity is being conducted by the Contractor) after all clearing and grubbing operations have been completed, but prior to completion of mass grading operations, in the drainage area of the location selected as the representative sampling location;
- In addition to (a) above, for each area of the site that discharges to a receiving water or from an outfall, the first rain event that reaches or exceeds 0.5 inch with a storm water discharge that occurs during normal business hours* either 90 days after the first sampling event or after all mass grading operations have been completed, but prior to submittal of a NOT, in the drainage area of the location selected as the representative sampling location, whichever comes first;
- At the time of sampling performed pursuant to (a) and (b) above, if BMPs in any area of the site that discharges to a receiving water or from an outfall are not properly designed, installed and maintained, corrective action shall be defined and implemented within two (2) business days, and turbidity samples shall be taken from discharges from that area of the site for each subsequent rain event that exceeds 0.5 inch during normal business hours* until the selected turbidity standard is attained, or until post-rain event inspections determine that BMPs are properly designed, installed and maintained;
- Where sampling pursuant to (a), (b), or (c) above is required but not possible (or not required because there was no discharge), the permittee, in accordance with part IV.D.4.a.(6), must include a written justification in the inspection report of why sampling was not performed. Providing this justification does not relieve the permittee of any subsequent sampling obligations under (a), (b) or (c) above; and
- Existing construction activities, i.e., those that occur occurring on or before the effective date of this permit, that have met the sampling required by (a) above shall sample in accordance with (b), those existing construction activities that have met the sampling required by (b) above shall not be required to conduct additional sampling other than as required by (c) above.

*Note that the Contractor (or certified personnel provided by the Contractor) may choose to meet the requirements of 1. and 2. above by collecting turbidity samples from any rain event that reaches or exceeds 0.5 inch and allows for monitoring at any time of the day or week.

REPORTING

- The applicable permittees are required to submit the sampling results to the EPD by the fifteenth day of the month following the reporting period. Reporting periods are months during which samples are taken in accordance with this permit. Sampling results shall be in a clearly legible format. Upon written notification, EPD may require the applicable permittee to submit the sampling results on a more frequent basis. Sampling and analysis of any stormwater discharge(s) or the receiving water(s) beyond the minimum frequency stated in this permit must be reported in a similar manner to the EPD. Sampling reports must be submitted to EPD using the electronic submittal service provided by EPD. Sampling reports must be submitted to EPD until such time as a NOT is submitted in accordance with Part VI.

- All sampling reports shall include the following information:
 - The rainfall amount, date, exact place and time of sampling or measurements;
 - The name(s) of the certified personnel who performed the sampling and measurements;
 - The date(s) analyses were performed;
 - The time(s) analyses were initiated;
 - The name(s) of the certified personnel who performed the analyses;
 - References and written procedures, when available, for the analytical techniques or methods used;
 - The results of such analyses, including the bench sheets, instrument readouts, computer disks or tapes, etc., used to determine these results;
 - Results which exceed 1000 NTU shall be reported as "exceeds 1000 NTU;" and
 - Certification statement that sampling was conducted as per the Plan.

- All written correspondence required by this permit shall be submitted by return receipt certified mail (or similar service) to the appropriate District Office of the EPD or delivery receipt email to the appropriate EPD District Office resource mailbox according to the schedule in Appendix A of this permit. The permittee shall retain a copy of the proof of submittal at the construction site or the proof of submittal shall be readily available at a designated location from commencement of construction until such time as a NOT is submitted in accordance with Part VI.

Retention of Records:

- The primary permittee shall retain the following records at the construction site or the records shall be readily available at a designated alternate location from commencement of construction until such time as a NOT is submitted in accordance with Part VI:
 - A copy of all Notices of Intent submitted to EPD;
 - A copy of the Erosion, Sedimentation and Pollution Control Plan required by this permit;
 - The design professional's report of the results of the inspection conducted in accordance with Part IV.A.5 of this permit;
 - A copy of all sampling information, results, and reports required by this permit;
 - A copy of all inspection reports generated in accordance with Part IV.D.4.a. of this permit;
 - A copy of all violation summaries and violation summary reports generated in accordance with Part III.D.2. of this permit; and
 - Daily rainfall information collected in accordance with Part IV.D.4.a.(2). of this permit.
- Copies of all Notices of Intent, Notices of Termination, inspection reports, sampling reports (including all calibration and maintenance records and all original strip chart recordings for continuous monitoring instrumentation), or other reports requested by the EPD, Erosion, Sedimentation and Pollution Control Plans, records of all data used to complete the Notice of Intent to be covered by this permit and all other records required by this permit shall be retained by the permittee who either produced or used it for a period of at least three years from the date that the NOT is submitted in accordance with Part VI of this permit. These records must be maintained at the permittee's primary place of business or at a designated alternative location once the construction activity has ceased at the permitted site. This period may be extended by request of the EPD at any time upon written notification to the permittee.

CERTIFICATION - ES&PC DESIGN PROFESSIONAL

"I certify that the permittee's Erosion, Sedimentation and Pollution Control Plan provides for an appropriate and comprehensive system of best management practices required by the Georgia Water Quality Control Act and the document "Manual for Erosion and Sediment Control in Georgia" (Manual) published by the Georgia Soil and Water Conservation Commission as of January 1 of the year in which the land-disturbing activity was permitted. The plan provides for the sampling of the receiving water(s) or the sampling of the storm water outfalls. The design system of best management practices and sampling methods is expected to meet the requirements contained in the General NPDES Permit No. GAR100002."

"I certify under penalty of law that this plan was prepared after a site visit to the locations described herein by myself and/or my authorized agent, under my direct supervision."

"I certify that the permittee's Erosion, Sedimentation and Pollution Control Plan provides for the monitoring of (a) all perennial and intermittent streams and other water bodies shown on the USGS topographic map and all other field-verified perennial and intermittent streams and other water bodies, or (b) where any such specific identified perennial or intermittent stream and other water body is not proposed to be sampled, I have determined in my professional judgment, utilizing the factors required in the General NPDES Permit No. GAR 100002, that the increase in the turbidity of each specific identified sampled receiving water will be representative of the increase in the turbidity of a specific identified un-sampled receiving water."

"I certify under penalty of law that this document and all attachments were prepared under my direction or supervision in accordance with a system designed to ensure that qualified personnel properly gather and evaluate the information submitted. Based on my inquiry of the person or persons who manage the system, or those persons directly responsible for gathering the information, the information submitted is, to the best of my knowledge and belief, true, accurate, and complete. I am aware that there are significant penalties for submitting false information, including the possibility of fine and imprisonment for knowing violations."

Wiley Helm

1/15/2026




DATE

P.E. - LICENSE NO. 051941
GSWCC LEVEL II CERTIFICATION NO. 107814

IMPAIRED STREAM REQUIREMENTS, TMDL PLANS, AND ALTERNATIVE BMP NOTES:




- THIS PROJECT IS LOCATED WITHIN ONE LINEAR MILE AND WITHIN THE SAME WATERSHED AS MULBERRY RIVER. MULBERRY RIVER IS NON-SUPPORTING FOR ITS DESIGNATED USE AS SHOWN ON GEORGIA'S 2020 "305(b)/303(d) LIST DOCUMENTS" FROM MULBERRY CREEK TO LITTLE MULBERRY RIVER. THE CRITERION VIOLATED IS "FC, BIO M." THE POTENTIAL CAUSE IS "UR" AND THE CATEGORY IS "4a." UNDER PART III.C.2. OF THE CURRENT GENERAL PERMIT NUMBER GAR100002 BY THE GEORGIA ENVIRONMENTAL PROTECTION DIVISION, THE EROSION, SEDIMENTATION, AND POLLUTION CONTROL PLAN FOR THIS PROJECT MUST INCLUDE AT LEAST FOUR OF THE LISTED BEST MANAGEMENT PRACTICES (PART III.C.2. - (I) FOR THOSE AREAS OF THE SITE WHICH DISCHARGE INTO OR WITHIN ONE LINEAR MILE UPSTREAM AND WITHIN THE SAME WATERSHED AS MULBERRY RIVER, THE FOLLOWING FOUR BEST MANAGEMENT PRACTICES ARE INCLUDED IN THIS PROJECT IN ORDER TO SATISFY THIS REQUIREMENT:
 - REDUCE THE TOTAL PLANNED SITE DISTURBANCE TO LESS THAN 50% IMPERVIOUS SURFACES (EXCLUDING ANY STATE-MANDATED BUFFER AREAS FROM SUCH CALCULATIONS)
 - IMPERVIOUS SURFACES ON THIS PROJECT INCLUDE THE INSTALLATION OF AN ACCESS ROAD, TWO WELL HOUSES, STORAGE TANK, AND TREATMENT BUILDING FOR A TOTAL OF 1.0 ACRES, WHICH IS LESS THAN 50% OF THE 4.48 TOTAL DISTURBED AREAAGE.
 - USE APPROPRIATE EROSION CONTROL SLOPE STABILIZATION INSTEAD OF CONCRETE IN ALL CONSTRUCTION STORM WATER DITCHES AND STORM DRAINAGES DESIGNED FOR A 25-YEAR, 24-HOUR RAINFALL EVENT.
 - CERTIFIED PERSONNEL FOR PRIMARY PERMITTEES SHALL CONDUCT INSPECTIONS AT LEAST TWICE EVERY SEVEN (7) CALENDAR DAYS AND WITHIN 24 HOURS OF THE END OF THE STORM THAT IS 0.5 INCHES RAINFALL OR GREATER IN ACCORDANCE WITH SECTION IV.D.4.A.(3)(A) - (C); SECONDARY PERMITTEES, SECTION IV.D.4.B.(3) (A) - (C); AND TERTIARY PERMITTEES SECTION IV.D.4.C.(3)(A) - (C) *
 - CONDUCT INSPECTIONS DURING THE INTERMEDIATE GRADING AND DRAINAGE BMP PHASE AND DURING THE FINAL BMP PHASE OF THE PROJECT BY THE DESIGN PROFESSIONAL WHO PREPARED THE PLAN IN ACCORDANCE WITH SECTION IV.A.5 OF THE PERMIT.
- THE PRIMARY PERMITTEE MUST RETAIN THE DESIGN PROFESSIONAL WHO PREPARED THE PLAN TO CONDUCT INSPECTIONS DURING THE INTERMEDIATE GRADING AND DRAINAGE BMP PHASE AND DURING THE FINAL BMP PHASE.
- SINCE FINAL TMDL PLAN FOR SEDIMENT IS NOT SITE SPECIFIC, COMPLIANCE WITH THE NPDES PERMIT SHOULD SATISFY LOAD REDUCTION REQUIREMENTS.
- ALTERNATIVE BMP'S WILL NOT BE INSTALLED DURING THIS PROJECT.

STORM DRAIN OUTLET PROTECTION

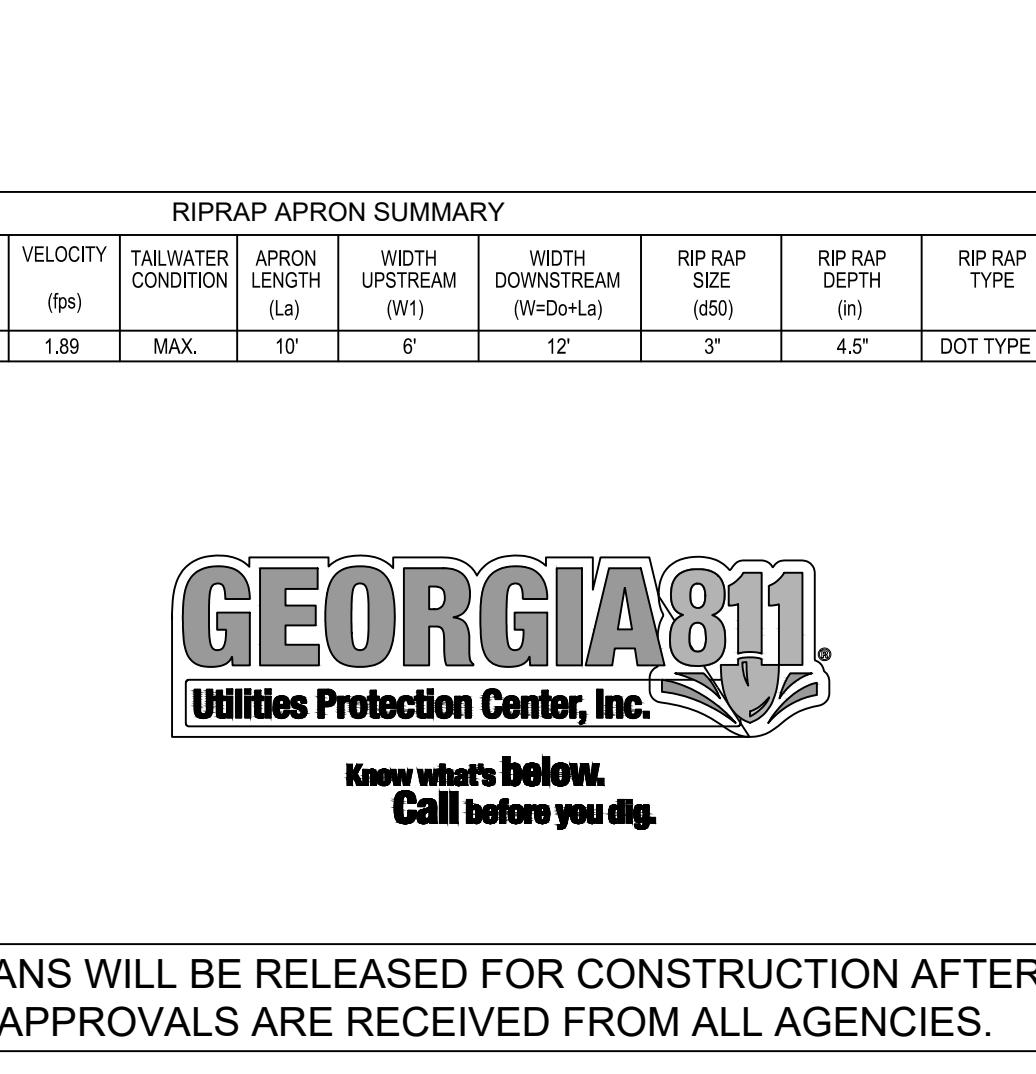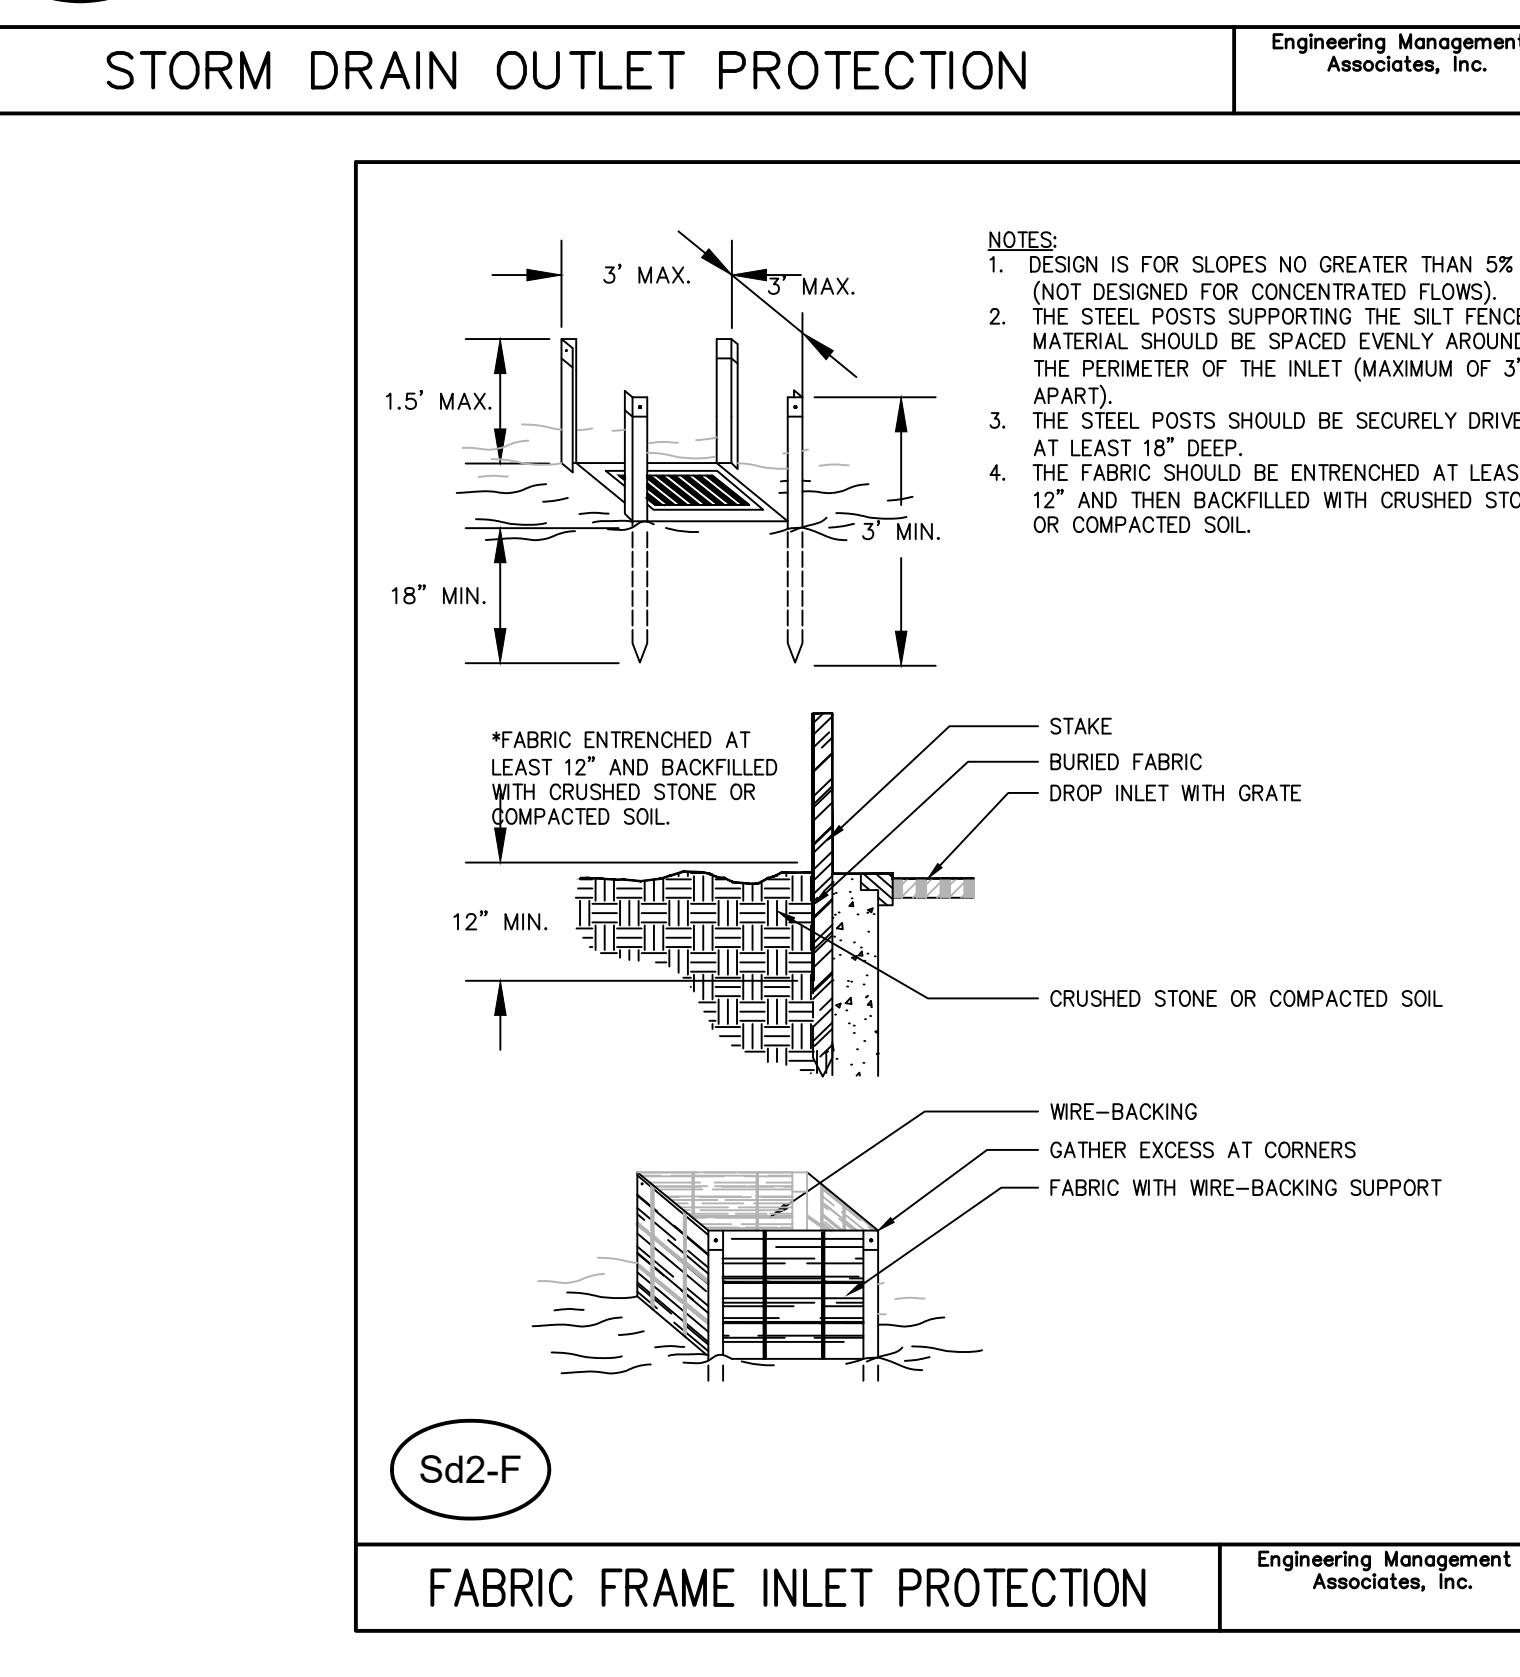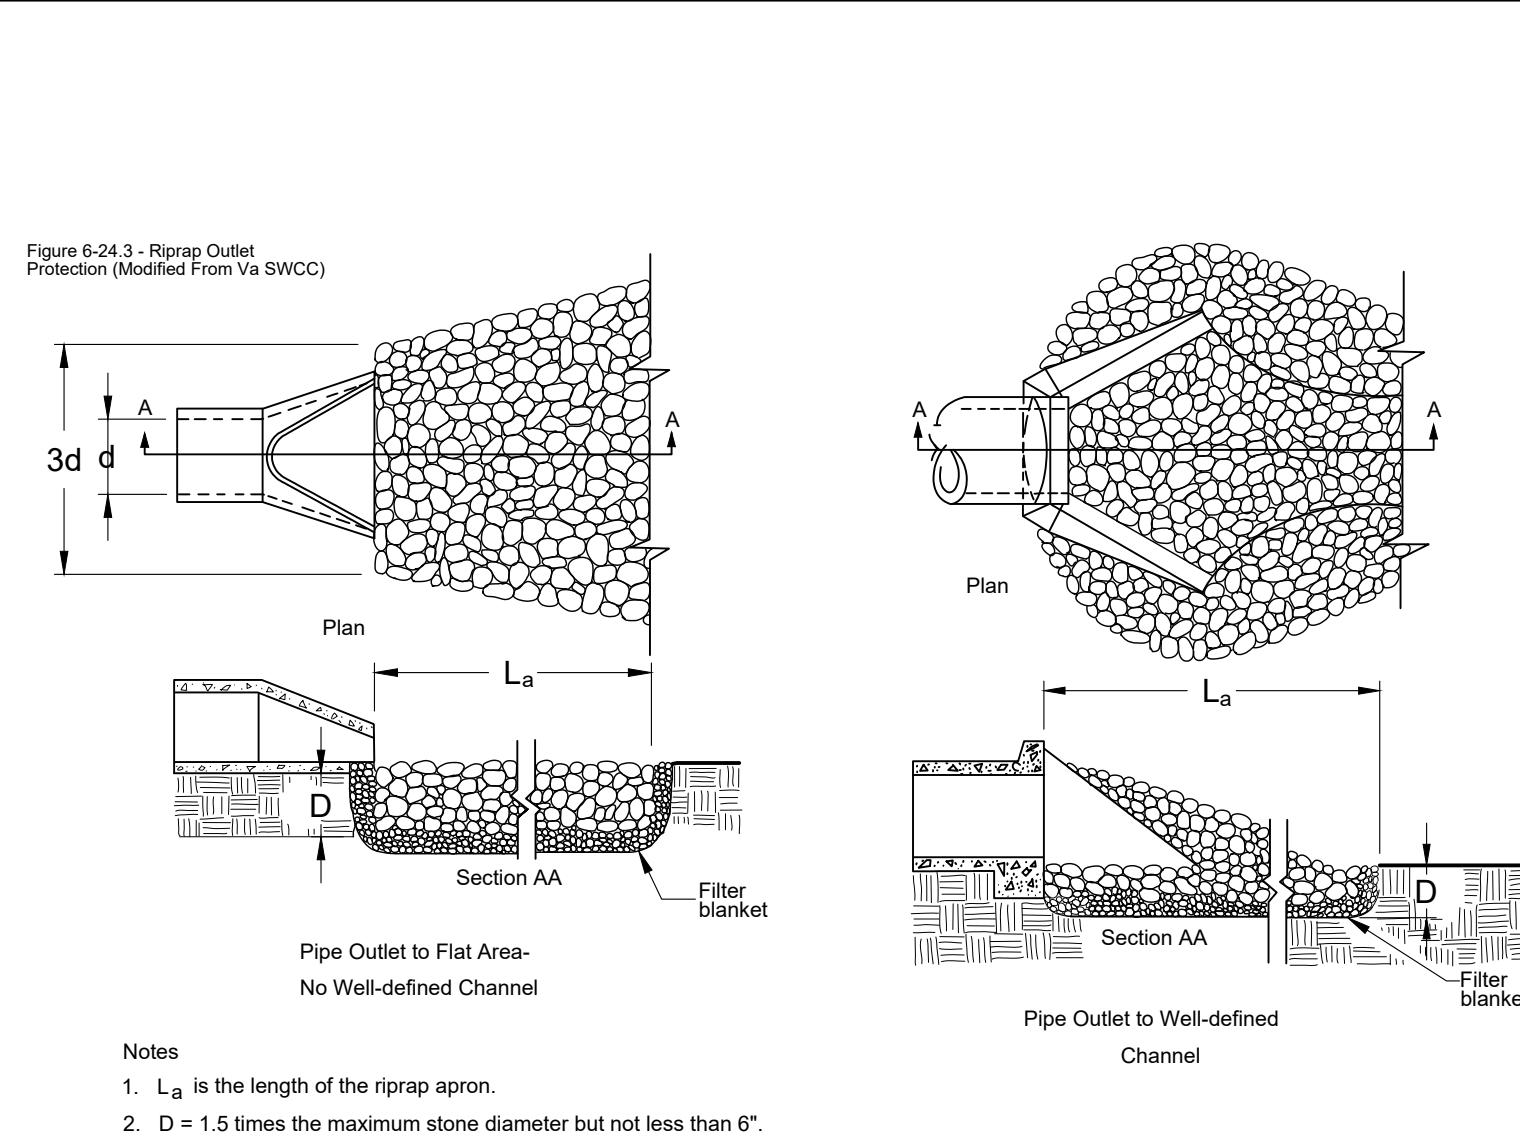

© 1996
Engineering Management, Inc.
All rights reserved.
These construction documents and/or plans are the property of Engineering Management, Inc. They are to be used only for the project named on the cover and are not to be reproduced or copied in whole or in part without the written consent of the owner. Any unauthorized use, reproduction, or copying of these documents is a violation of federal and state laws.

REVISION

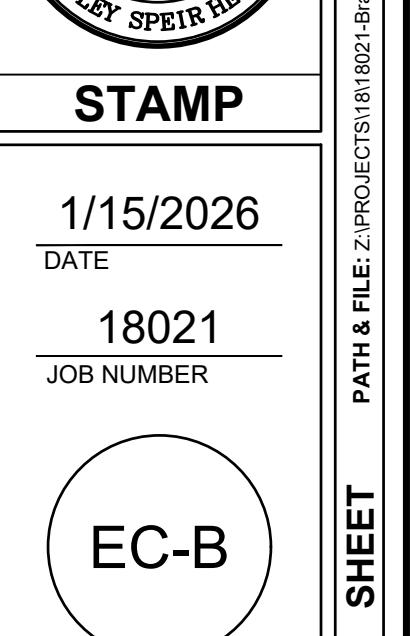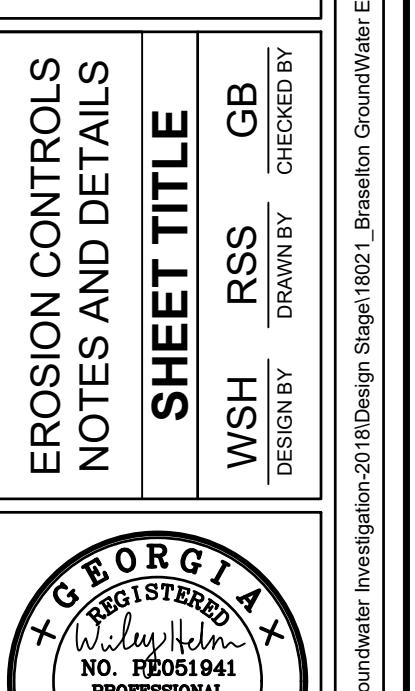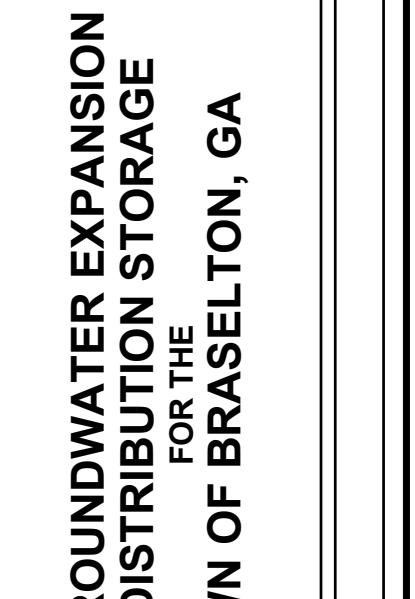


SHEET NOTES:

1. RECEIVING WATERS, WHICH ARE WITHIN 200 FEET OF THE PROJECT SITE, ARE LABELED AS "STATE WATER"
2. SEE THE EROSION, SEDIMENTATION AND POLLUTION CONTROL PLAN DOCUMENT (APPENDIX A OF THE PROJECT TECHNICAL SPECIFICATIONS) OR PLAN SHEET ECB FOR ADDITIONAL INFORMATION REGARDING RECEIVING WATERS AND SAMPLING REQUIREMENTS. SEE SHEETS EC1-EC5-3 FOR DETAILED LOCATION OF SAMPLE POINTS.
3. A SITE VISIT DETERMINED THAT THERE ARE NO WETLANDS IN THE VICINITY OF THIS PROJECT.

WATERSHED INFORMATION

WATERSHED	TOTAL ACREAGE	DESCRIPTION OF AREAS WITHIN THE WATERSHED	RUNOFF COEFFICIENT (C) PRIOR TO CONSTRUCTION	RUNOFF COEFFICIENT (C) POST CONSTRUCTION
DRAINAGE BASIN A FOR STATE & RECEIVING WATER #1 - MULBERRY RIVER	±164.45	WOODED, RESIDENTIAL, PAVED ROADS, UNDEVELOPED LAND, LAWNS, COMMERCIAL, LIGHT INDUSTRIAL	0.38	0.52

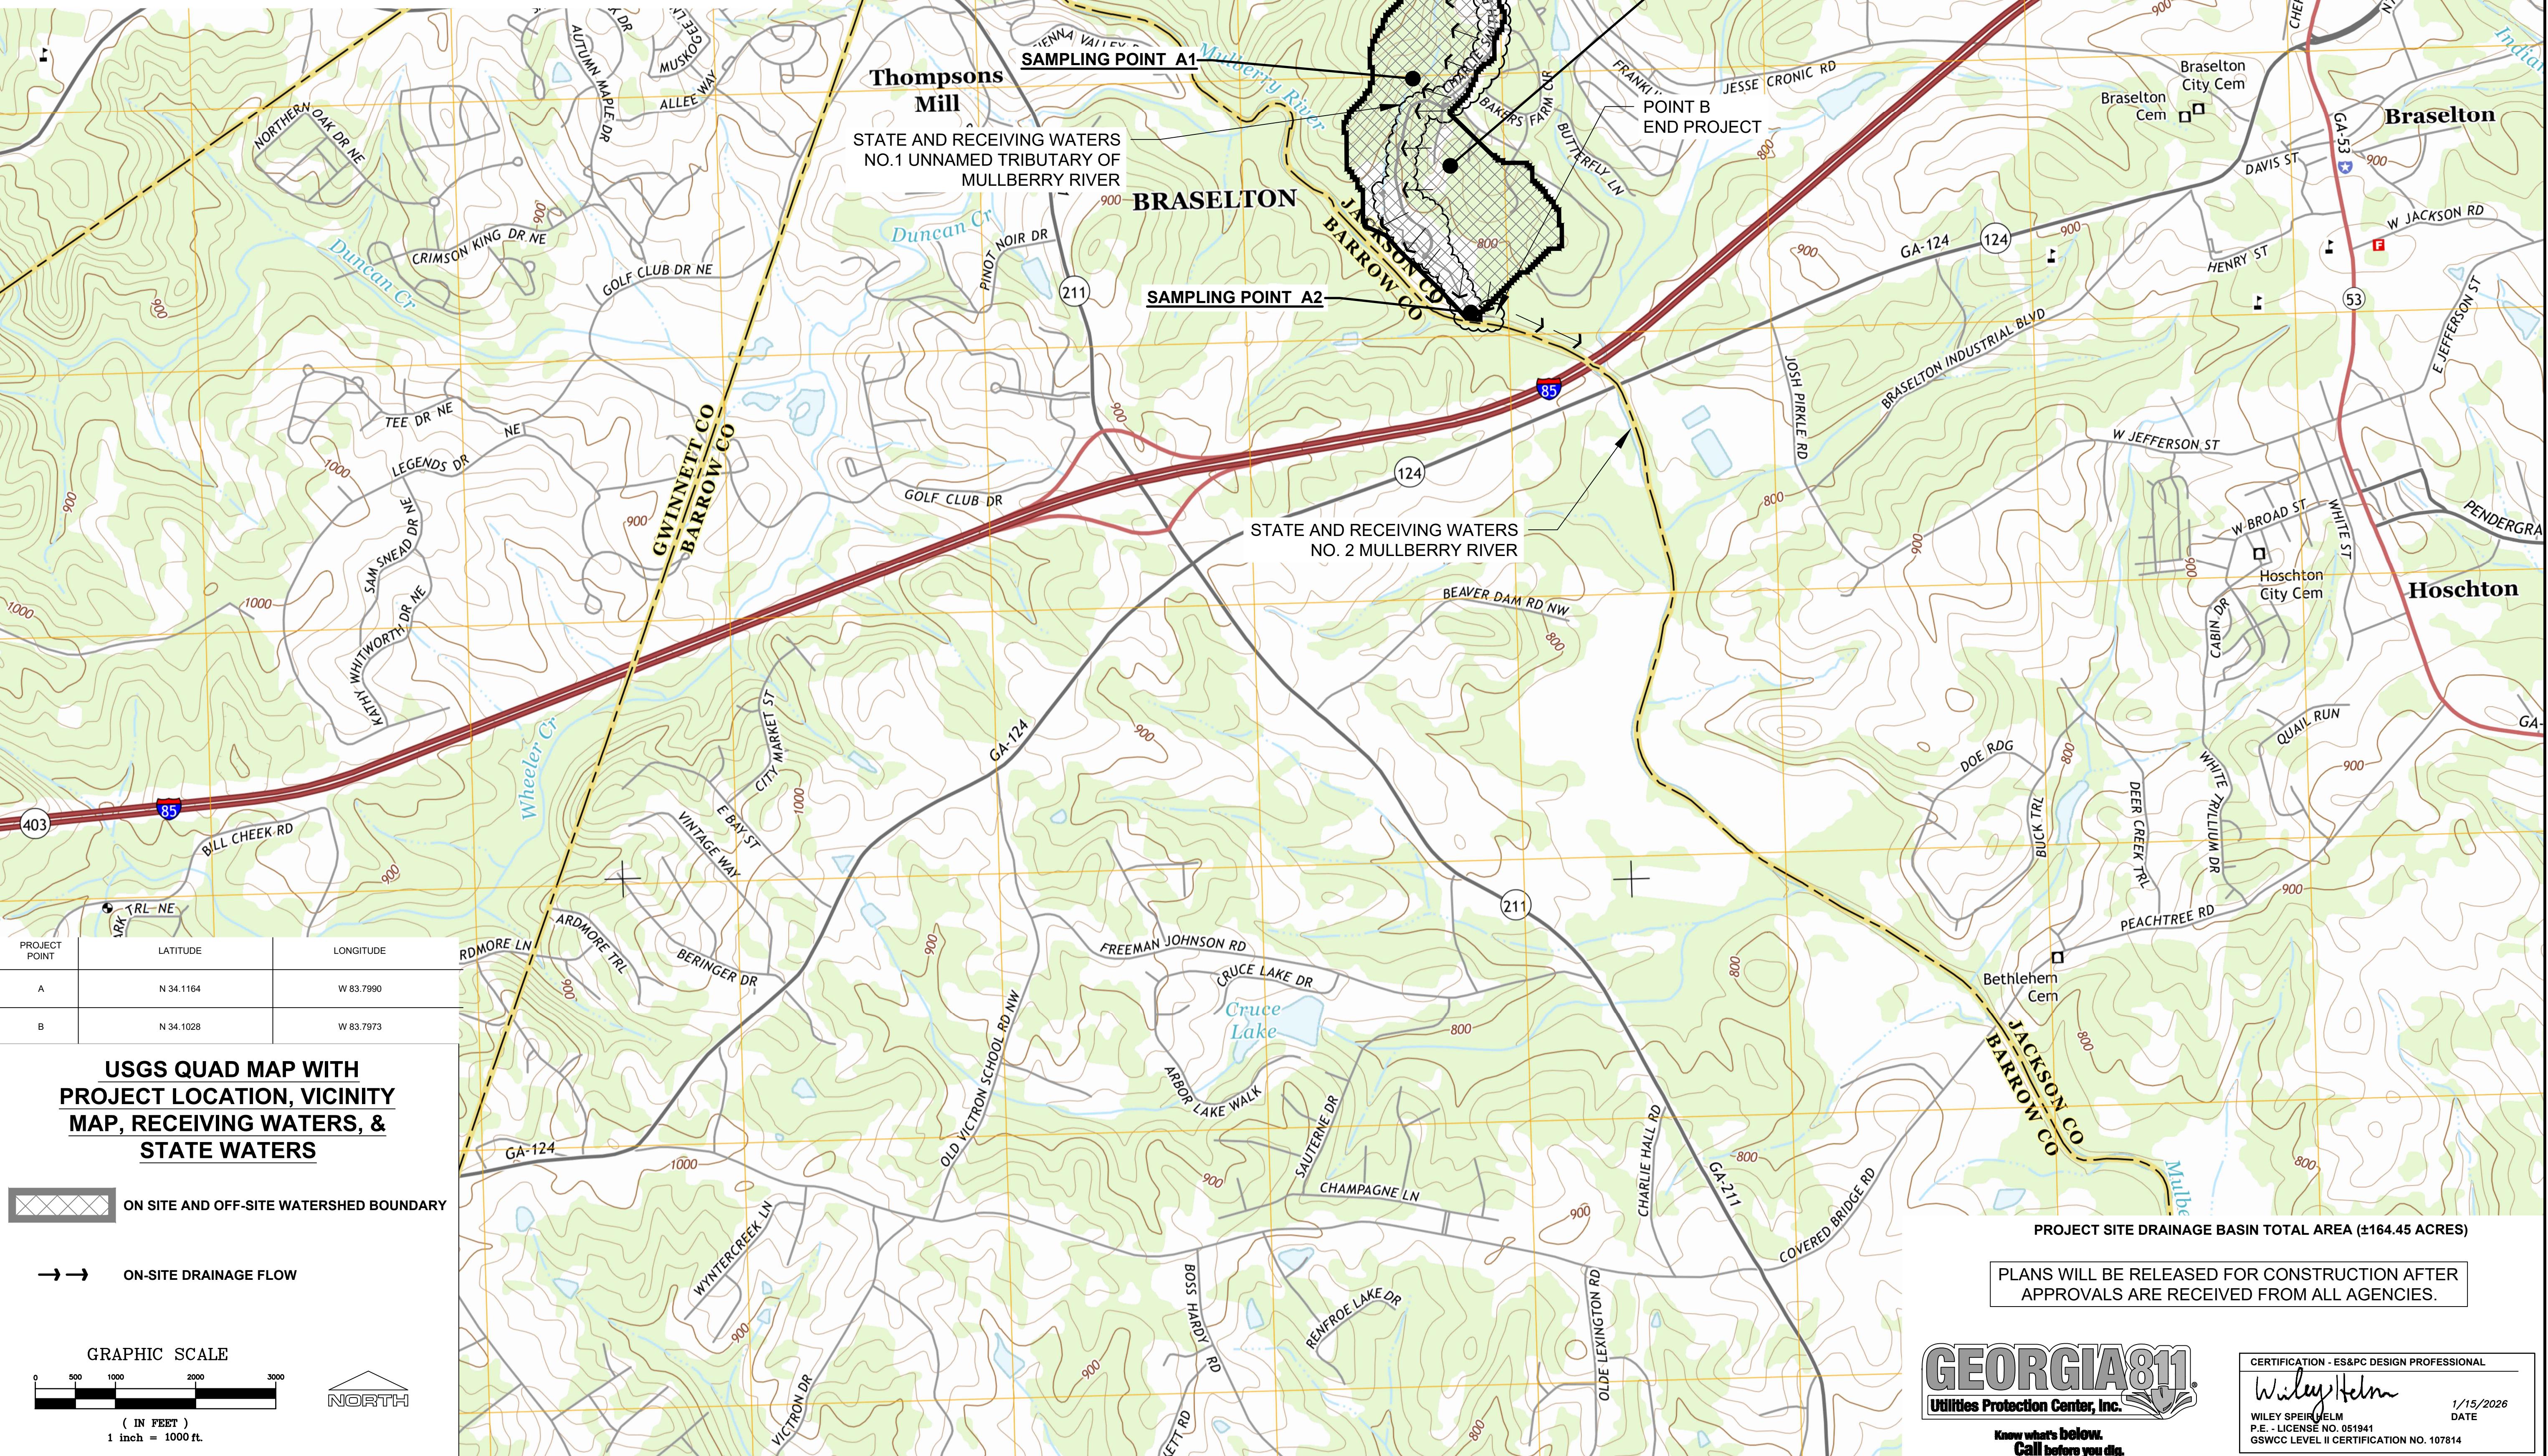

© 1996
Engineering Management, Inc.
All Rights Reserved

REVISION

EMI ENGINEERING
MANAGEMENT
Experience • Trust • Solutions
Civil and Environmental Engineers
303 Swanson Drive, Lawrenceville, GA 30043
Phone 770-462-1387 Fax 770-962-3010
www.eminc.com

**2026 GROUNDWATER EXPANSION
AND DISTRIBUTION STORAGE
FOR THE
TOWN OF BRASELTON, GA**

EROSION CONTROLS
NOTES AND DETAILS
SHEET TITLE
WHS RSS GB
DRAWN BY
DESIGNED BY

STAMP
1/15/2026
DATE
18021
JOB NUMBER

SHEET
1/15/2026
DATE
18021
JOB NUMBER
